

Thursday, 8/2/2007 12:07:45 PM  
User: Kim Johnston

## Process Sheet

Customer	: CU-DAR001 Dart Helicopters Services	Drawing Name	: AFT TUBE ASSEMBLY
Job Number	: 30697		
Estimate Number	: 10699		
P.O. Number	: N/A	Part Number	: D3391025
This Issue	: 2/8/2007	Drawing Number	: D3391 REV E
Prsht Rev.	: NC	Project Number	: N/A
First Issue	: N/A	Drawing Revision	: E
Previous Run	: 30696	Material	: N/A
		Due Date	: 3/2/2007
Written By	:	Qty:	1 Um: Each
Checked & Approved By	:		
Comment	: Est Rev B 06-02-07 ECN773 dwg rev. D EC Est Rev: C 06-03-28 Update Manufacturing Instructions JLM		

## Additional Product

Job Number:



ISE

Seq. #:	Machine Or Operation:	Description:
---------	-----------------------	--------------

1.0	D6014090	ALUMINUM EXTRUSION
-----	----------	--------------------



Comment: Qty: 1.0000 f(s)/Unit Total: 1.0000 f(s)

ALUMINUM EXTRUSION

Pick:

Qty	Part Number	Description	Batch
1	D6014-090	Extrusion	D26546

Identify as D3391-3

JF 07/02/13

2.0	MORI SEIKI	MORI SEIKI CNC LATHE LARGE
-----	------------	----------------------------



Comment: MORI SEIKI CNC LATHE LARGE

Turn as per Folio FA599 Rev: &amp; Dwg D3391 Rev: E

JF 07/02/13

3.0	QC2	INSPECT PARTS AS THEY COME OFF MACHINE
-----	-----	--



Comment: INSPECT PARTS AS THEY COME OFF MACHINE

JF 07/02/14

4.0	HAAS1	HAAS CNC VERTICAL MACHINING #1
-----	-------	--------------------------------



Comment: HAAS

1-Machine as per Folio FA 599 Rev: DA &amp; Dwg D3391 Rev: E

2-Drill ( PILOT HOLE) aft cap holes per Dwg D3391 using DT8803

3-Deburr

E 07/02/15

Part A

# WORK ORDER CHANGES

DATE	STEP	PROCEDURE CHANGE	By	Date	Qty	Approval Chief Eng / Prod Mgr	Approval QC Inspector

Part No: \_\_\_\_\_ PAR #: \_\_\_\_\_ Fault Category: \_\_\_\_\_ NCR: Yes ☒ No ☐ DQA: PD Date: 07/02/27  
 QA: N/C Closed: \_\_\_\_\_ Date: \_\_\_\_\_

NCR:		WORK ORDER NON-CONFORMANCE (NCR)						
DATE	STEP	Description of NC Section A	Corrective Action Section B			Verification Section C	Approval Chief Eng	Approval QC Inspector
			Initial Chief Eng	Action Description Chief Eng	Sign & Date			
07/02/27	4.2	Drill Sq moved when drill in pilot hole rft of tube causing a double hole.	DT 07.02.21 per QSI 042	OPEN HOLE TO FINISHED SIZE OF $\phi 0.209$ VERIFY IF ANY HOLE ELONGATION IS PRESENT	PD 07/02/27	07.02.21	QSI 042	07.02.21

NOTE: Date & initial all entries

# Process Sheet

Customer: CU-DAR001 Dart Helicopters Services

Drawing Name: AFT TUBE ASSEMBLY

Job Number: 30697

Part Number: D3391025

Job Number:



Seq. #:

Machine Or Operation:

Description :

5.0

QC2

INSPECT PARTS AS THEY COME OFF MACHINE



Comment: INSPECT PARTS AS THEY COME OFF MACHINE

SD 07/02/15 x1

6.0

QC8

SECOND CHECK



Comment: SECOND CHECK

SD 07.02.21

7.0

BENDING

BENDING MACHINE



Comment: NC Bender

Form as per Dwg D3391 Using Bend Prog 3391025

DP 7-2-21

8.0

QC5

INSPECT WORK TO CURRENT STEP



Comment: INSPECT WORK TO CURRENT STEP

BE 07-02-21

9.0

LANDING GEAR 1

LANDING GEAR RESOURCE 1



Comment: LANDING GEAR RESOURCE 1

- 1-Open Aft cap pilot hole to .208" as per Dwg D3391
- 2-Drill Tube as per D3391 using DT8809 (HOLES MARKED "A" ONLY)
- 3-Drill and c' sink wearshoe holes as per Dwg D3391 Using DT8878(Mid Tube) & DT8217 Wearplate Jig
- 4-C'sink holes for float bag (4 holes per side) as per Dwg D3391
- 5-Deburr

4 VERIFY IF ANY HOLE ELONGATION EXISTS

BE 07-02-22

15D 7-1-24

Tools: mill

10.0

QC5

INSPECT WORK TO CURRENT STEP



PH 07.02.23



Comment: INSPECT WORK TO CURRENT STEP

Refer to let us know if you have

11.0

HAND FINISHING1

HAND FINISHING RESOURCE #1



Comment: HAND FINISHING RESOURCE #1


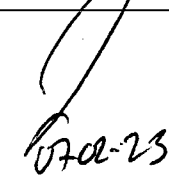
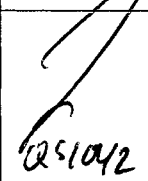
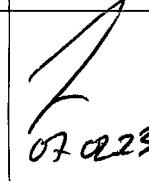
Acid etch and Alodine as per QSI 005 4.1

m-h/2.11

01/02/24

W/O: 22		WORK ORDER CHANGES						
DATE	STEP	PROCEDURE CHANGE	By	Date	Qty	Approval Chief Eng / Prod Mgr	Approval QC Inspector	

Part No: \_\_\_\_\_ PAR #: \_\_\_\_\_ Fault Category: \_\_\_\_\_ NCR: Yes ☒ No ☐ DQA: ☒ Date: 07/02/23  
 QA: N/C Closed: \_\_\_\_\_ Date: \_\_\_\_\_

NCR:		WORK ORDER NON-CONFORMANCE (NCR)						
DATE	STEP	Description of NC Section A	Corrective Action Section B			Verification Section C	Approval Chief Eng	Approval QC Inspector
			Initial Chief Eng	Action Description Chief Eng	Sign & Date			
07-02-23	Q-0	During step 4.2, the Altigors hole was started incorrectly. Hole is to be verified when opened @ step 9.0.	 Q51042	Hole was a little mark on the outside edge. Hole acceptable. Minor appearance.	BE 07-02-23	 07-02-23	 Q51042	 07-02-23

NOTE: Date & initial all entries

Date: Thursday, 2/8/2007 12:07:45 PM

User: Kira Johnstoh

## Process Sheet

Customer: CU-DAR001 Dart Helicopters Services

Drawing Name: AFT TUBE ASSEMBLY

Job Number: 30697

Part Number: D3391025

Job Number:



Seq. #:

Machine Or Operation:

Description :

12.0

POWDER COATING

POWDER COATING



M103141



①

Comment: POWDER COATING

Powder Coat White Gloss (Ref: 4.3.5.1) as per QSI 005 4.3

m-h/a.m

07/02/24

13.0

QC3

INSPECT POWDER COAT/CHEMICAL CONVERSION



Comment: INSPECT POWDER COAT/CHEMICAL CONVERSION

SAD 07/02/24

①

14.0

NAS1330C3KB166

INSERT



Comment: Qty.: 8.0000 Each(s)/Unit Total : 8.0000 Each(s)

INSERT

Pick:

Qty

Part Number

Description

Batch

8

NAS1330C3KB166

Insert

B100732

a.m 07/02/24

①

15.0

HAND FINISHING1

HAND FINISHING RESOURCE #1



Comment: HAND FINISHING RESOURCE #1

Install Inserts as per dwg

a.m 07/02/24

①

16.0

QC5

INSPECT WORK TO CURRENT STEP



Comment: INSPECT WORK TO CURRENT STEP

Jotir-26 ①

a.m 07/02/24 ①

17.0

AESS10KB366

INSERT



Comment: Qty.: 14.0000 Each(s)/Unit Total : 14.0000 Each(s)

Insert

Pick:

Qty

Part Number

Description

Batch

14

AESS10KB366 Insert

M102642

a.m 07/02/24

①

18.0

AESS10KB266

INSERT



Comment: Qty.: 2.0000 Each(s)/Unit Total : 2.0000 Each(s)

INSERT

Pick:

Qty

Part Number

Description

Batch

2

AESS10KB266

Insert

or NAS1330C3KB266

B12905

m-h/a.m 07/02/24

①

W/O:		WORK ORDER CHANGES						
DATE	STEP	PROCEDURE CHANGE		By	Date	Qty	Approval Chief Eng / Prod Mgr	Approval QC Inspector

Part No: \_\_\_\_\_ PAR #: \_\_\_\_\_ Fault Category: \_\_\_\_\_ NCR: Yes No DQA: \_\_\_\_\_ Date: \_\_\_\_\_

QA: N/C Closed: \_\_\_\_\_ Date: \_\_\_\_\_

NCR:		WORK ORDER NON-CONFORMANCE (NCR)						
DATE	STEP	Description of NC Section A	Corrective Action Section B			Verification Section C	Approval Chief Eng	Approval QC Inspector
			Initial Chief Eng	Action Description Chief Eng	Sign & Date			

NOTE: Date & initial all entries

Date: Thursday, 2/8/2007 12:07:45 PM  
User: Kim Johnston

## Process Sheet

Customer: CU-DAR001 Dart Helicopters Services

Drawing Name: AFT TUBE ASSEMBLY

Job Number: 30697

Part Number: D3391025

Job Number:



Seq. #:

Machine Or Operation:

Description :

19.0

AESS10KB316

INSERT



Comment: Qty.: 2.0000 Each(s)/Unit Total : 2.0000 Each(s)

INSERT

Pick:

Qty	Part Number	Description	Batch
2	AESS10KB316	Insert	
	or NAS1330C3KB316		

*M17905 m.p./am 02/02/24 (1)*

20.0

D2646

Aft Cap



Comment: Qty.: 1.0000 Each(s)/Unit Total : 1.0000 Each(s)

Aft Cap

Pick:

Qty	Part Number	Description	Batch
1	D2646	Aft Cap	

*B30119*

21.0

AN3C4A

BOLT



Comment: Qty.: 2.0000 Each(s)/Unit Total : 2.0000 Each(s)

Bolt

Pick:

Qty	Part Number	Description	Batch
2	AN3C4A	Bolt	

*m101390*

22.0

AN960C10L

washer



Comment: Qty.: 2.0000 Each(s)/Unit Total : 2.0000 Each(s)

Inventory

Pick:

Qty	Part Number	Description	Batch
2	AN960C10L	Washer	

*m103344*

23.0

NAS1515H3L

WASHER



Comment: Qty.: 2.0000 Each(s)/Unit Total : 2.0000 Each(s)

WASHER

Pick:

Qty	Part Number	Description	Batch
2	NAS1515H3L	Washer	

*m103481 m.p./am 02/02/24 (1)*

W/O:		WORK ORDER CHANGES						
DATE	STEP	PROCEDURE CHANGE		By	Date	Qty	Approval Chief Eng / Prod Mgr	Approval QC Inspector

Part No: \_\_\_\_\_ PAR #: \_\_\_\_\_ Fault Category: \_\_\_\_\_ NCR: Yes No DQA: \_\_\_\_\_ Date: \_\_\_\_\_

QA: N/C Closed: \_\_\_\_\_ Date: \_\_\_\_\_

NCR:		WORK ORDER NON-CONFORMANCE (NCR)						
DATE	STEP	Description of NC Section A	Corrective Action Section B			Verification Section C	Approval Chief Eng	Approval QC Inspector
			Initial Chief Eng		Action Description Chief Eng			

NOTE: Date & initial all entries



Date: Thursday, 2/8/2007 12:07:45 PM  
User: Kim Johnston

## Process Sheet

Customer: CU-DAR001 Dart Helicopters Services

Drawing Name: AFT TUBE ASSEMBLY

Job Number: 30697

Part Number: D3391025

Job Number:



Seq. #:

Machine Or Operation:

Description :

24.0

HAND FINISHING1

HAND FINISHING RESOURCE #1



Comment: SMALL & MEDIUM FAB RESOURCE 1

1-Install inserts as per Dwg D3391

2-Install Aft Cap as per Dwg D3391

A/R Sikaflex-2411-291 M102672

Sikaflex expiry date: 02/07

*a.m/m/07/02/24*

*U*

25.0

QC5

INSPECT WORK TO CURRENT STEP



Comment: INSPECT WORK TO CURRENT STEP

*07-02-26 ①*

*tt*

26.0

PACKAGING 1

PACKAGING RESOURCE #1



Comment: PACKAGING RESOURCE #1

Identify and Stock

Location: \_\_\_\_\_

**POSITIVE RECALL**

EFFECTIVE 07-02-23 AUTH PH

RELEASED 07-02-23 DATE PH

27.0

QC21

FINAL INSPECTION/W/O RELEASE



Comment: FINAL INSPECTION/W/O RELEASE

*07/02/27 ①*

Job Completion



*u 07-02-26*

W/O:		WORK ORDER CHANGES						
DATE	STEP	PROCEDURE CHANGE	By	Date	Qty	Approval Chief Eng / Prod Mgr	Approval QC Inspector	

Part No: \_\_\_\_\_ PAR #: \_\_\_\_\_ Fault Category: \_\_\_\_\_ NCR: Yes No DQA: \_\_\_\_\_ Date: \_\_\_\_\_

QA: N/C Closed: \_\_\_\_\_ Date: \_\_\_\_\_

NCR:		WORK ORDER NON-CONFORMANCE (NCR)						
DATE	STEP	Description of NC Section A	Corrective Action Section B			Verification Section C	Approval Chief Eng	Approval QC Inspector
			Initial Chief Eng		Action Description Chief Eng			

NOTE: Date & initial all entries

<b>DART AEROSPACE LTD</b>		<b>Work Order:</b>	30697
<b>Description:</b> Float Skidtube (412)		<b>Part Number:</b>	D3391-3
<b>Inspection Dwg:</b> D3391 <b>Rev:</b> E		<b>Page 1 of 1</b>	


### FIRST ARTICLE INSPECTION CHECKLIST

☒ First Article      ☐ Prototype

Drawing Dimension	Tolerance	Actual Dimension	Accept	Reject	Method of Inspection	Comments
14.000	+/-0.010	14.00	✓			
3.500	+/-0.010	3.495	✓			
88.93	+/-0.030	88.93	✓			
7 44.995	+/-0.030	45.00	✓		Tape	
3.200	+/-0.010	3.205	✓			
1.526	+0.000/-0.030	1.526	✓			
0.200	+/-0.010	0.202	✓			
7.500	+/-0.010	7.500	✓			
27.750	+/-0.010	27.750	✓		Tape	
31.750	+/-0.010	31.750	✓		Tape	
35.250	+/-0.010	35.250	✓		Tape	
0.400	+/-0.010	0.400	✓			
PA 07.02.21 7 <del>00.200</del>	<del>+0.005/-0.001</del>					
3.300	+/-0.010	3.301 / 3.310	✓			
0.200	+/-0.010	0.202	✓			
3.520	+/-0.010	3.530	✓			
0.687	+0.010/-0.000	0.687	✓			
R0.062	+/-0.010	0.062	✓			
Ø0.484	+0.005/-0.001	0.486	✓			

<b>Measured by:</b> J.P.	<b>Audited by:</b> SA	<b>Prototype Approval:</b>	N/A
<b>Date:</b> 07/02/13	<b>Date:</b> 07.02.21	<b>Date:</b>	N/A

Rev	Date	Change	Revised by	Approved
A	06.04.24	New Issue P/O D3391-025	KJ/JLM	
B	06.06.19	Dwg revision update	KJ/JLM	

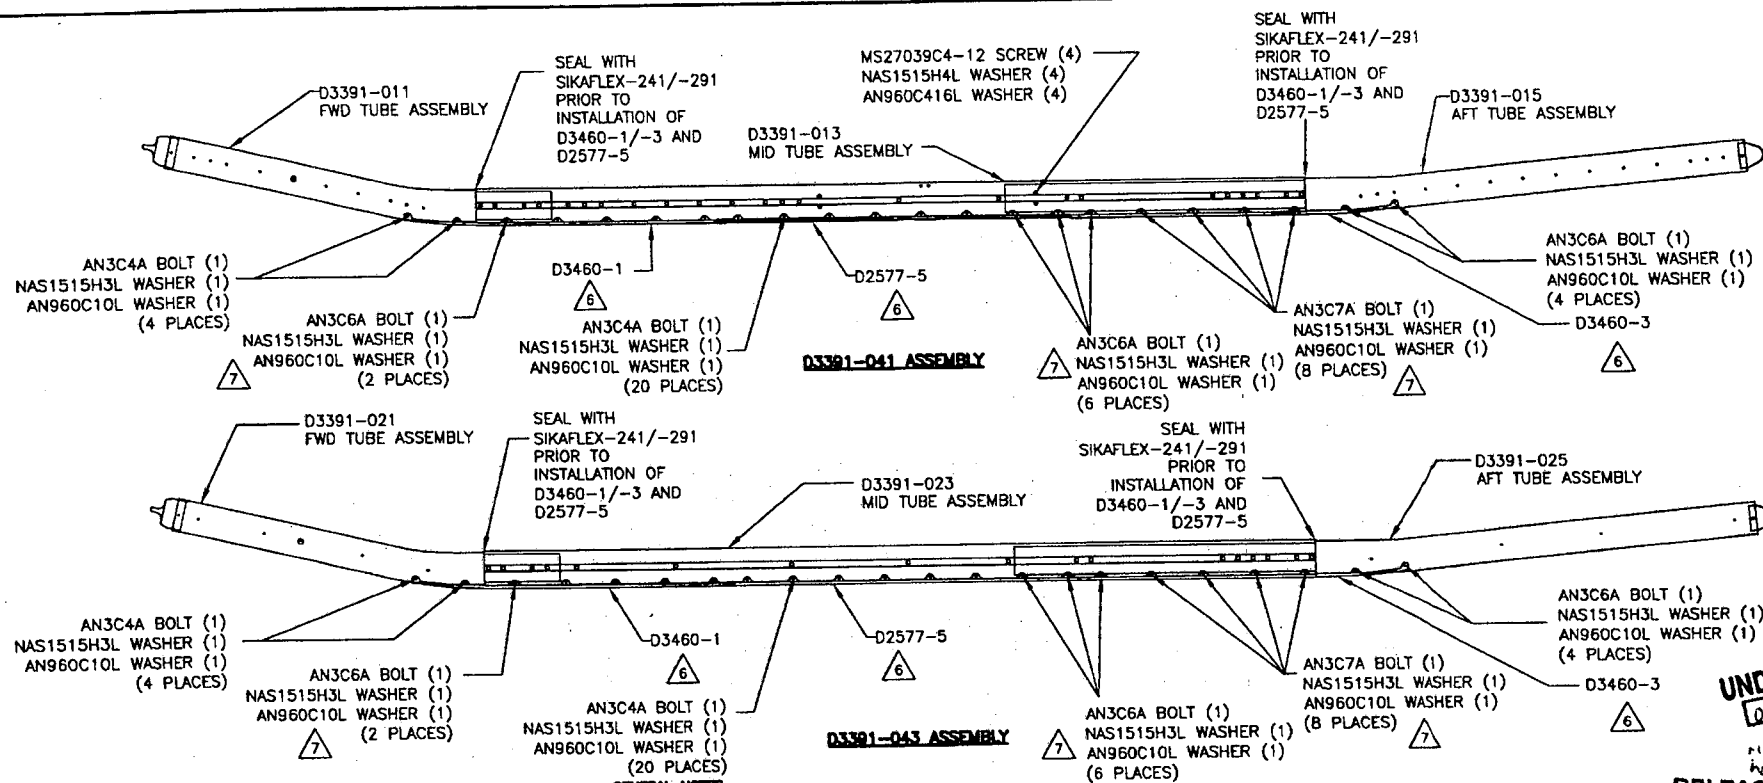

#### GENERAL NOTES

- 1) ALL DIMENSIONS ARE IN INCHES
- 2) TOLERANCES ARE PER DART QSI 018 UNLESS OTHERWISE NOTED
- 3) FINISH: ACID ETCH AND ALODINE PER DART QSI 005 4.1  
POWDER COAT WHITE (4.3.5.1) PER DART QSI 005 4.3
- 4) SPRAY INSIDE OF TUBE WITH A COAT OF LPS LABORATORIES "LPS-3" AFTER FINISH AND AFTER INSTALLATION OF INSERTS. COAT ALL EXPOSED FASTENERS WITH LPS LABORATORIES "LPS PROCYON" AFTER FINAL ASSEMBLY. CLEAN EXCESS OFF POWDER COATING WITH MEK DEGREASER.
- 5) USE DART DRILL TEMPLATE DT8217 TO LOCATE AND DRILL "E" SIZE HOLES (#0.250-#0.257) FOR WEARSHOE INSERTS.
- 6) C/SINK #0.391/#0.425 x 100" AS APPLICABLE AND INSTALL INSERTS EXCEPT WHERE INDICATED.
- 7) APPLY A LAYER OF SIKAFLEX -241/-291 ADHESIVE BETWEEN THE BOTTOM OF THE SKIDTUBE ASSEMBLY AND THE WEARPLATES
- 7) DO NOT TORQUE, HAND TIGHTEN ONLY

#### D3391-041/-043 FLOAT SKIDTUBE ASSEMBLY PARTS LIST

QTY - 041	QTY - 043	PART NUMBER	DESCRIPTION
X	X	D3391-041	FLOAT SKIDTUBE ASSEMBLY
		D3391-043	FLOAT SKIDTUBE ASSEMBLY
1		D3391-011	FWD TUBE ASSEMBLY
1		D3391-013	MID TUBE ASSEMBLY
1		D3391-015	AFT TUBE ASSEMBLY
	1	D3391-021	FWD TUBE ASSEMBLY
	1	D3391-023	MID TUBE ASSEMBLY
	1	D3391-025	AFT TUBE ASSEMBLY
24	24	AN3C4A	BOLT
12	12	AN3C6A	BOLT
8	8	AN3C7A	BOLT
44	44	NAS1515H3L	WASHER
44	44	AN960C10L	WASHER
4		MS27039C4-12	SCREW
4		NAS1515H4L	WASHER
4		AN960C416L	WASHER
1	1	D2577-5	WEARSHOE
1	1	D3460-1	WEARSHOE
1	1	D3460-3	WEARSHOE

SHOP COPY  
RETURN TO  
ENGINEERING  
UNCONTROLLED COPY  
SUBJECT TO AMENDMENT  
WITHOUT NOTICE  
NO WORK ORDER  
30697

UNDER REVIEW  
06.04.25








RELEASED

06.05.03

COPYRIGHT © 2005 BY DART AEROSPACE USA, INC.

THIS DOCUMENT IS PRIVATE AND CONFIDENTIAL AND IS SUPPLIED ON THE EXPRESS CONDITION THAT IT IS NOT TO BE USED FOR ANY PURPOSE OR COPIED OR COMMUNICATED TO ANY OTHER PERSON WITHOUT WRITTEN PERMISSION FROM DART AEROSPACE USA, INC.

E	06.04.25	CHANGE TOLERANCE, EASE MANUFACTURE
D	06.01.23	UPDATE TOLERANCE, CHANGE HOLE SIZE
C	05.09.27	LENGTHEN AFT EXTENSION
B	05.06.10	DRAWING UPDATES
A	05.02.07	NEW ISSUE
DESIGN	PH	DRAWN BY PH
CHECKED	PH	APPROVED
DATE	06.04.25	TITLE
		412 FLOAT SKIDTUBE
		REV. E
		SHEET 1 OF 5
		SCALE
		NTS

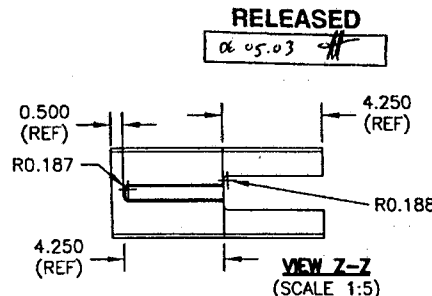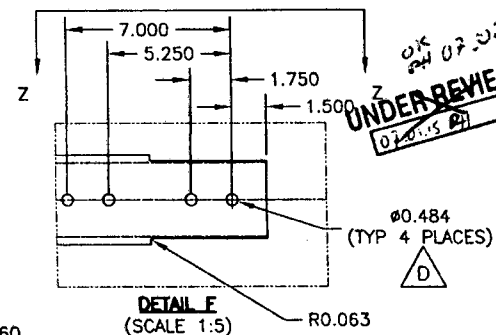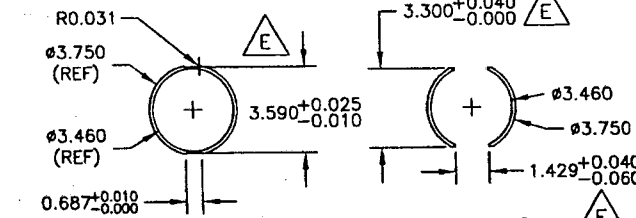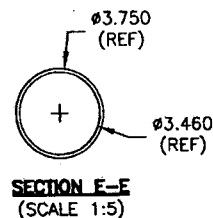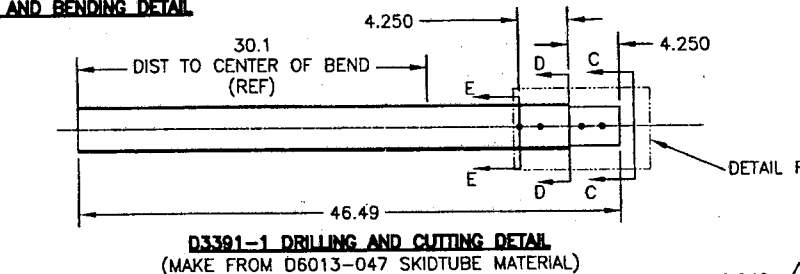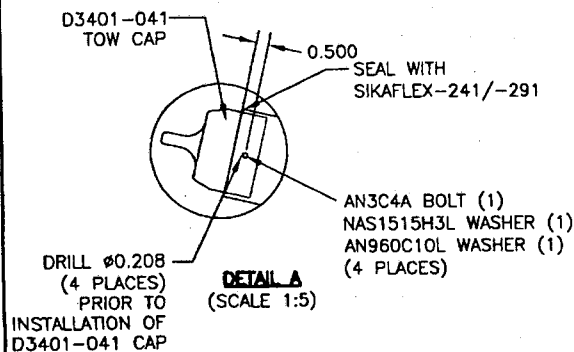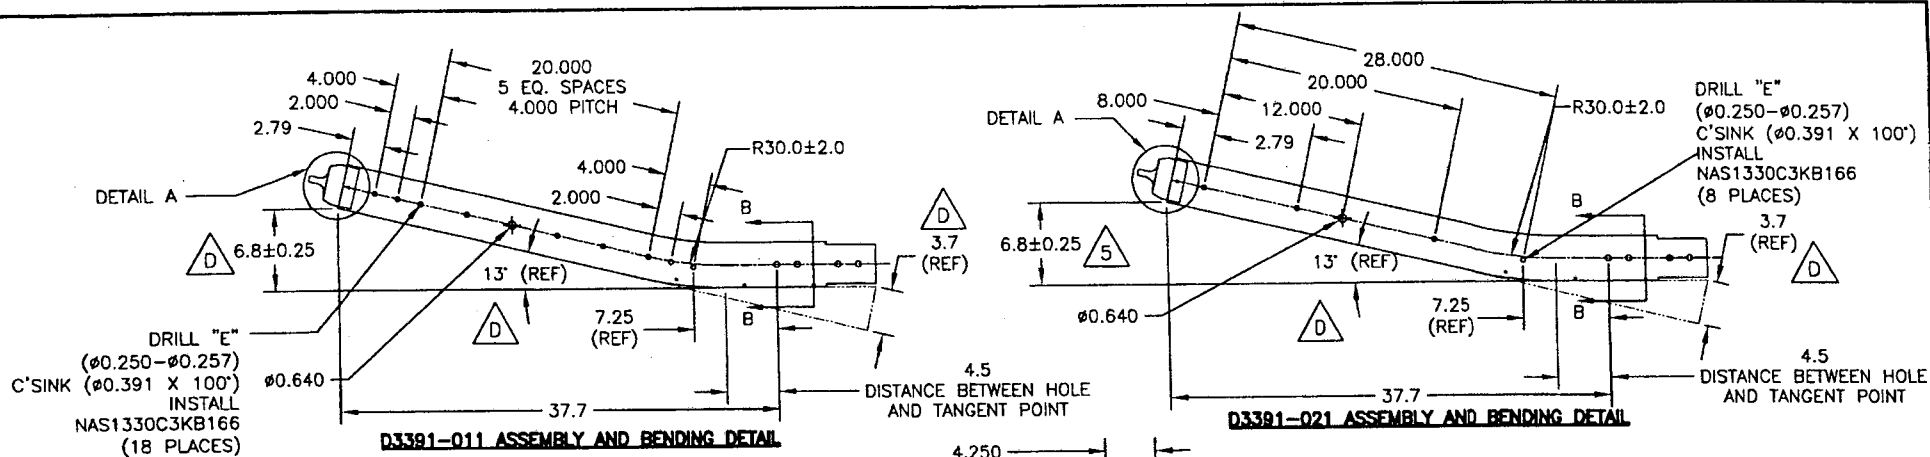

**D3391-011/-021 FWD TUBE ASSEMBLY PARTS LIST**

QTY - 011	QTY - 021	PART NUMBER	DESCRIPTION
X	X	D3391-011	FWD TUBE ASSEMBLY
		D3391-021	FWD TUBE ASSEMBLY
1	1	D6013-047	FWD TUBE
1	1	D3401-041	TOW CAP
4	4	AN3C4A	BOLT
4	4	NAS1515H3L	WASHER
4	4	AN960C10L	WASHER
24	14	NAS1330C3KB166	INSERT


NO COPY  
30647  
UNCONTROLLED COPY  
SUBJECT TO ADVERTISEMENT  
WITHOUT NOTICE  
RETURN TO  
ENGINEERING  
MOB ORDER

COPYRIGHT © 2005 BY DART AEROSPACE USA, INC.



THIS DOCUMENT IS PRIVATE AND CONFIDENTIAL AND IS SUPPLIED ON THE EXPRESS CONDITION THAT IT IS NOT TO BE USED FOR ANY PURPOSE OR COPIED OR COMMUNICATED TO ANY OTHER PERSON WITHOUT WRITTEN PERMISSION FROM DART AEROSPACE USA, INC.

DESIGN PH	DRAWN BY PH	<b>DART</b> DART AEROSPACE USA, INC. PORT HADLOCK, MA
CHECKED #	APPROVED #	DRAWING NO. D3391
DATE 06.04.25	TITLE 412 FLOAT SKIDTUBE	REV. E SHEET 2 OF 5 SCALE 1:10



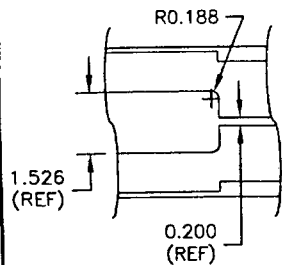


VIEW BB-BB  
(SCALE 1:3)

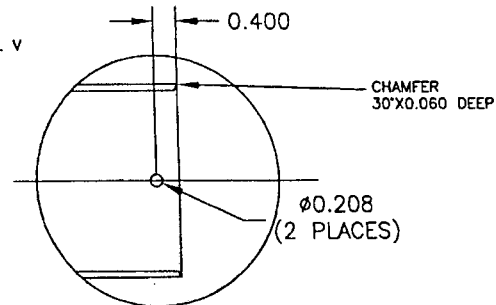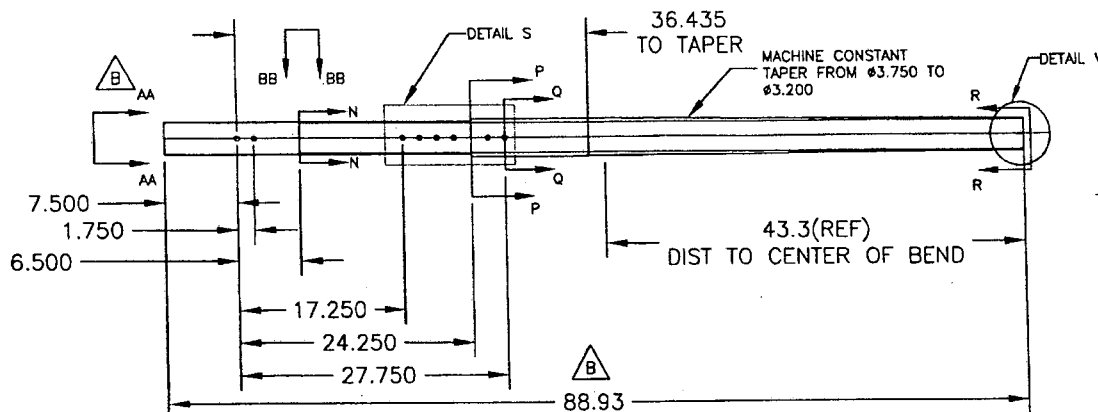


DETAIL V  
(SCALE 1:2)


D3391-3 AFT DRILLING AND CUTTING DETAIL  
(MAKE FROM D6014-090 SKIDTUBE MATERIAL)

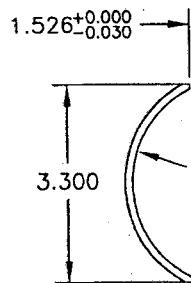


SECTION AA-AA  
(SCALE 1:2)

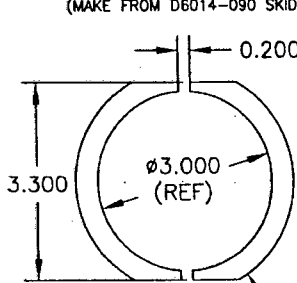


SECTION N-N  
(SCALE 1:2)

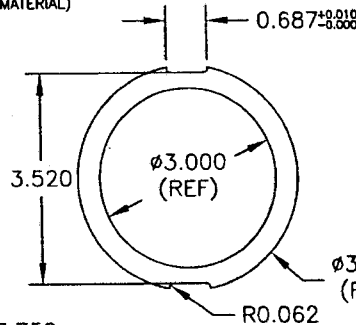


SECTION P-P  
(SCALE 1:2)

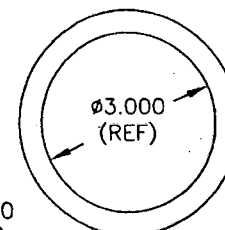


SECTION Q-Q  
(SCALE 1:2)

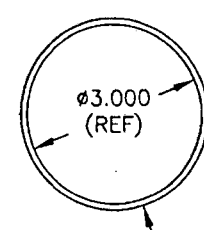

SECTION R-R  
(SCALE 1:2)

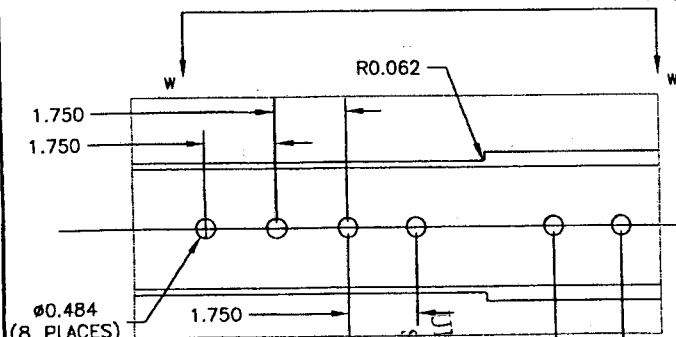

DETAIL S  
(SCALE 1:3)

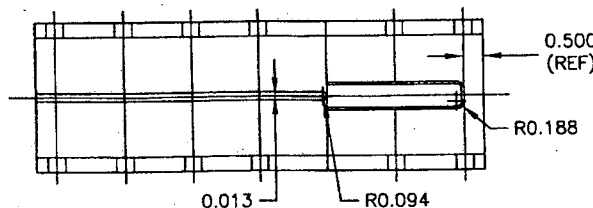

VIEW W-W  
(SCALE 1:3)





07-02-07  
UNDER REVIEW  
07-11-07  
RELEASED  
05-03

COPYRIGHT © 2005 BY DART AEROSPACE USA, INC.

THIS DOCUMENT IS PRIVATE AND CONFIDENTIAL  
AND IS SUPPLIED ON THE EXPRESS CONDITION  
THAT IT IS NOT TO BE USED FOR ANY PURPOSE  
OR COPIED OR COMMUNICATED TO ANY OTHER  
PERSON WITHOUT WRITTEN PERMISSION FROM  
DART AEROSPACE USA, INC.

DESIGN	PH	DRAWN BY	PH	<b>DART</b> DART AEROSPACE USA, INC. PORT HADLOCK, OH	REV. E
CHECKED	#	APPROVED	#	DRAWING NO. D3391	SHEET 4 OF 5
DATE	06.04.25	TITLE	412 FLOAT SKIDTUBE	SCALE	1:12

NO. 30617  
WORK ORDER  
UNCONTROLLED COPY  
SUBJECT TO AMENDMENT  
WITHOUT NOTICE  
RETURN TO  
ENGINEERING  
SHOP COPY

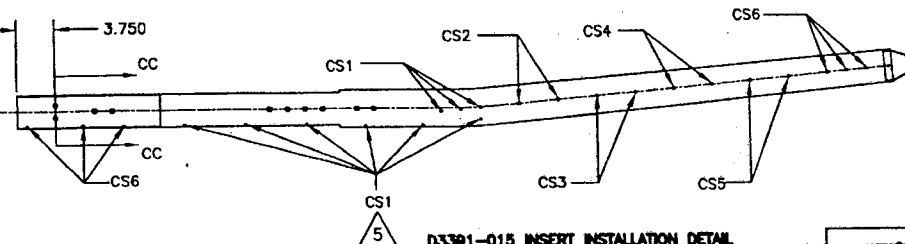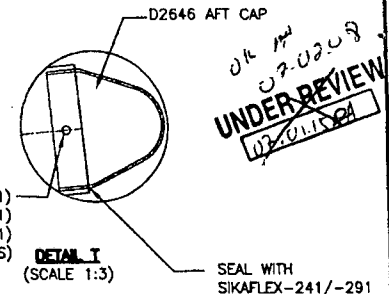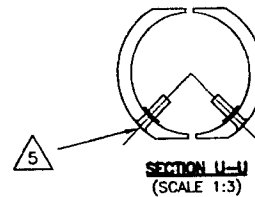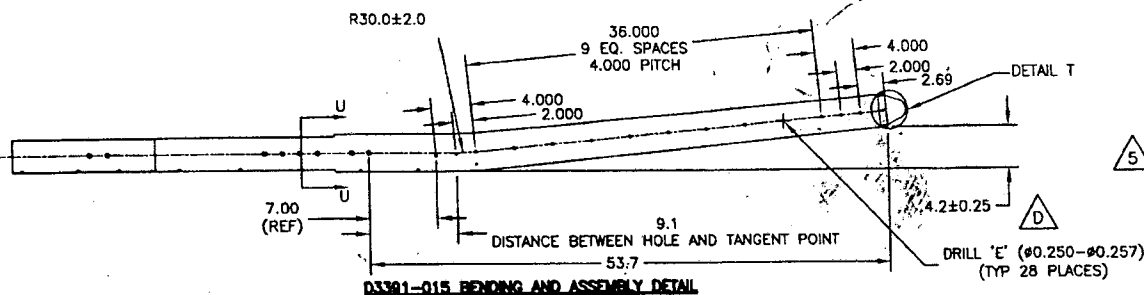


C'SINK AND INSTALL AESS10KBXXX AND/OR NAS1330C3KBXXX IN HOLES MARKED CS1-CS6 AS FOLLOWS


HOLES MARKED	QTY D3391-015	QTY D3391-025	C'SINK	P/N
CS1	18	14	Ø0.425	AESS10KB396
CS2	2	2	Ø0.391	AESS10KB396
CS3	2	2	Ø0.391	NAS1330C3KB216
CS4	2	2	Ø0.391	NAS1330C3KB216
CS5	2	2	Ø0.391	NAS1330C3KB216
CS6	12	8	Ø0.391	NAS1330C3KB166

# D3391-015/-025 AFT TUBE ASSEMBLY PARTS LIST

QTY - 015	QTY - 025	PART NUMBER	DESCRIPTION
X		D3391-015	AFT TUBE ASSEMBLY
	X	D3391-025	AFT TUBE ASSEMBLY
1	1	D6014-090	AFT TUBE
1	1	D2646	AFT CAP
18	14	AESS10KB396	INSERT
4	2	NAS1330C3KB318	INSERT
4	2	NAS1330C3KB286	INSERT
4	2	NAS1330C3KB216	INSERT
12	8	NAS1330C3KB166	INSERT
4	2	NAS1330C4KB151	INSERT
2	2	AN304A	BOLT
2	2	NAS1515H3L	WASHER
2	2	AN960C10L	WASHER

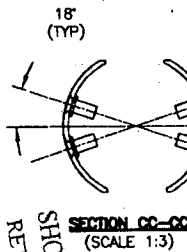

DRILL 'G' (#0.332-#0.338)  
C'SINK (#0.529X100#)  
NAS1330C4KB151 INSERT (1)  
(4 PLACES)

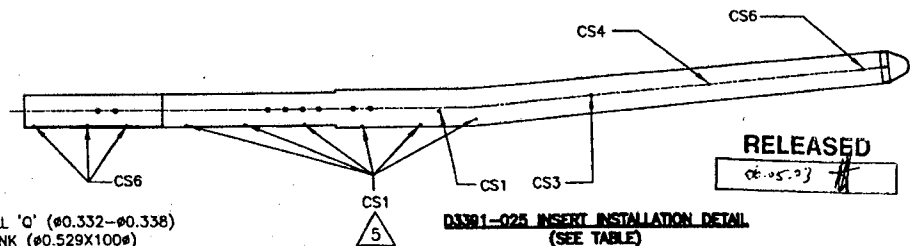


COPYRIGHT © 2005 BY DART AEROSPACE USA, INC.

THIS DOCUMENT IS PRIVATE AND CONFIDENTIAL AND IS SUPPLIED ON THE EXPRESS CONDITION THAT IT IS NOT TO BE USED FOR ANY PURPOSE OR COPIED OR COMMUNICATED TO ANY OTHER PERSON WITHOUT WRITTEN PERMISSION FROM DART AEROSPACE USA, INC.

DESIGN	PH	DRAWN BY	PH	<b>DART</b> DART AEROSPACE USA, INC.
CHECKED		APPROVED		PORT HADLOCK, MA
DATE	06.04.25	DRAWING NO.	D3391	REV. E
		TITLE	412 FLOAT SKIDTUBE	SHEET 5 OF 5
				SCALE

UNCONTROLLED COPY  
SUBJECT TO AMENDMENT  
WITHOUT NOTICE  
WORK ORDER  
30627



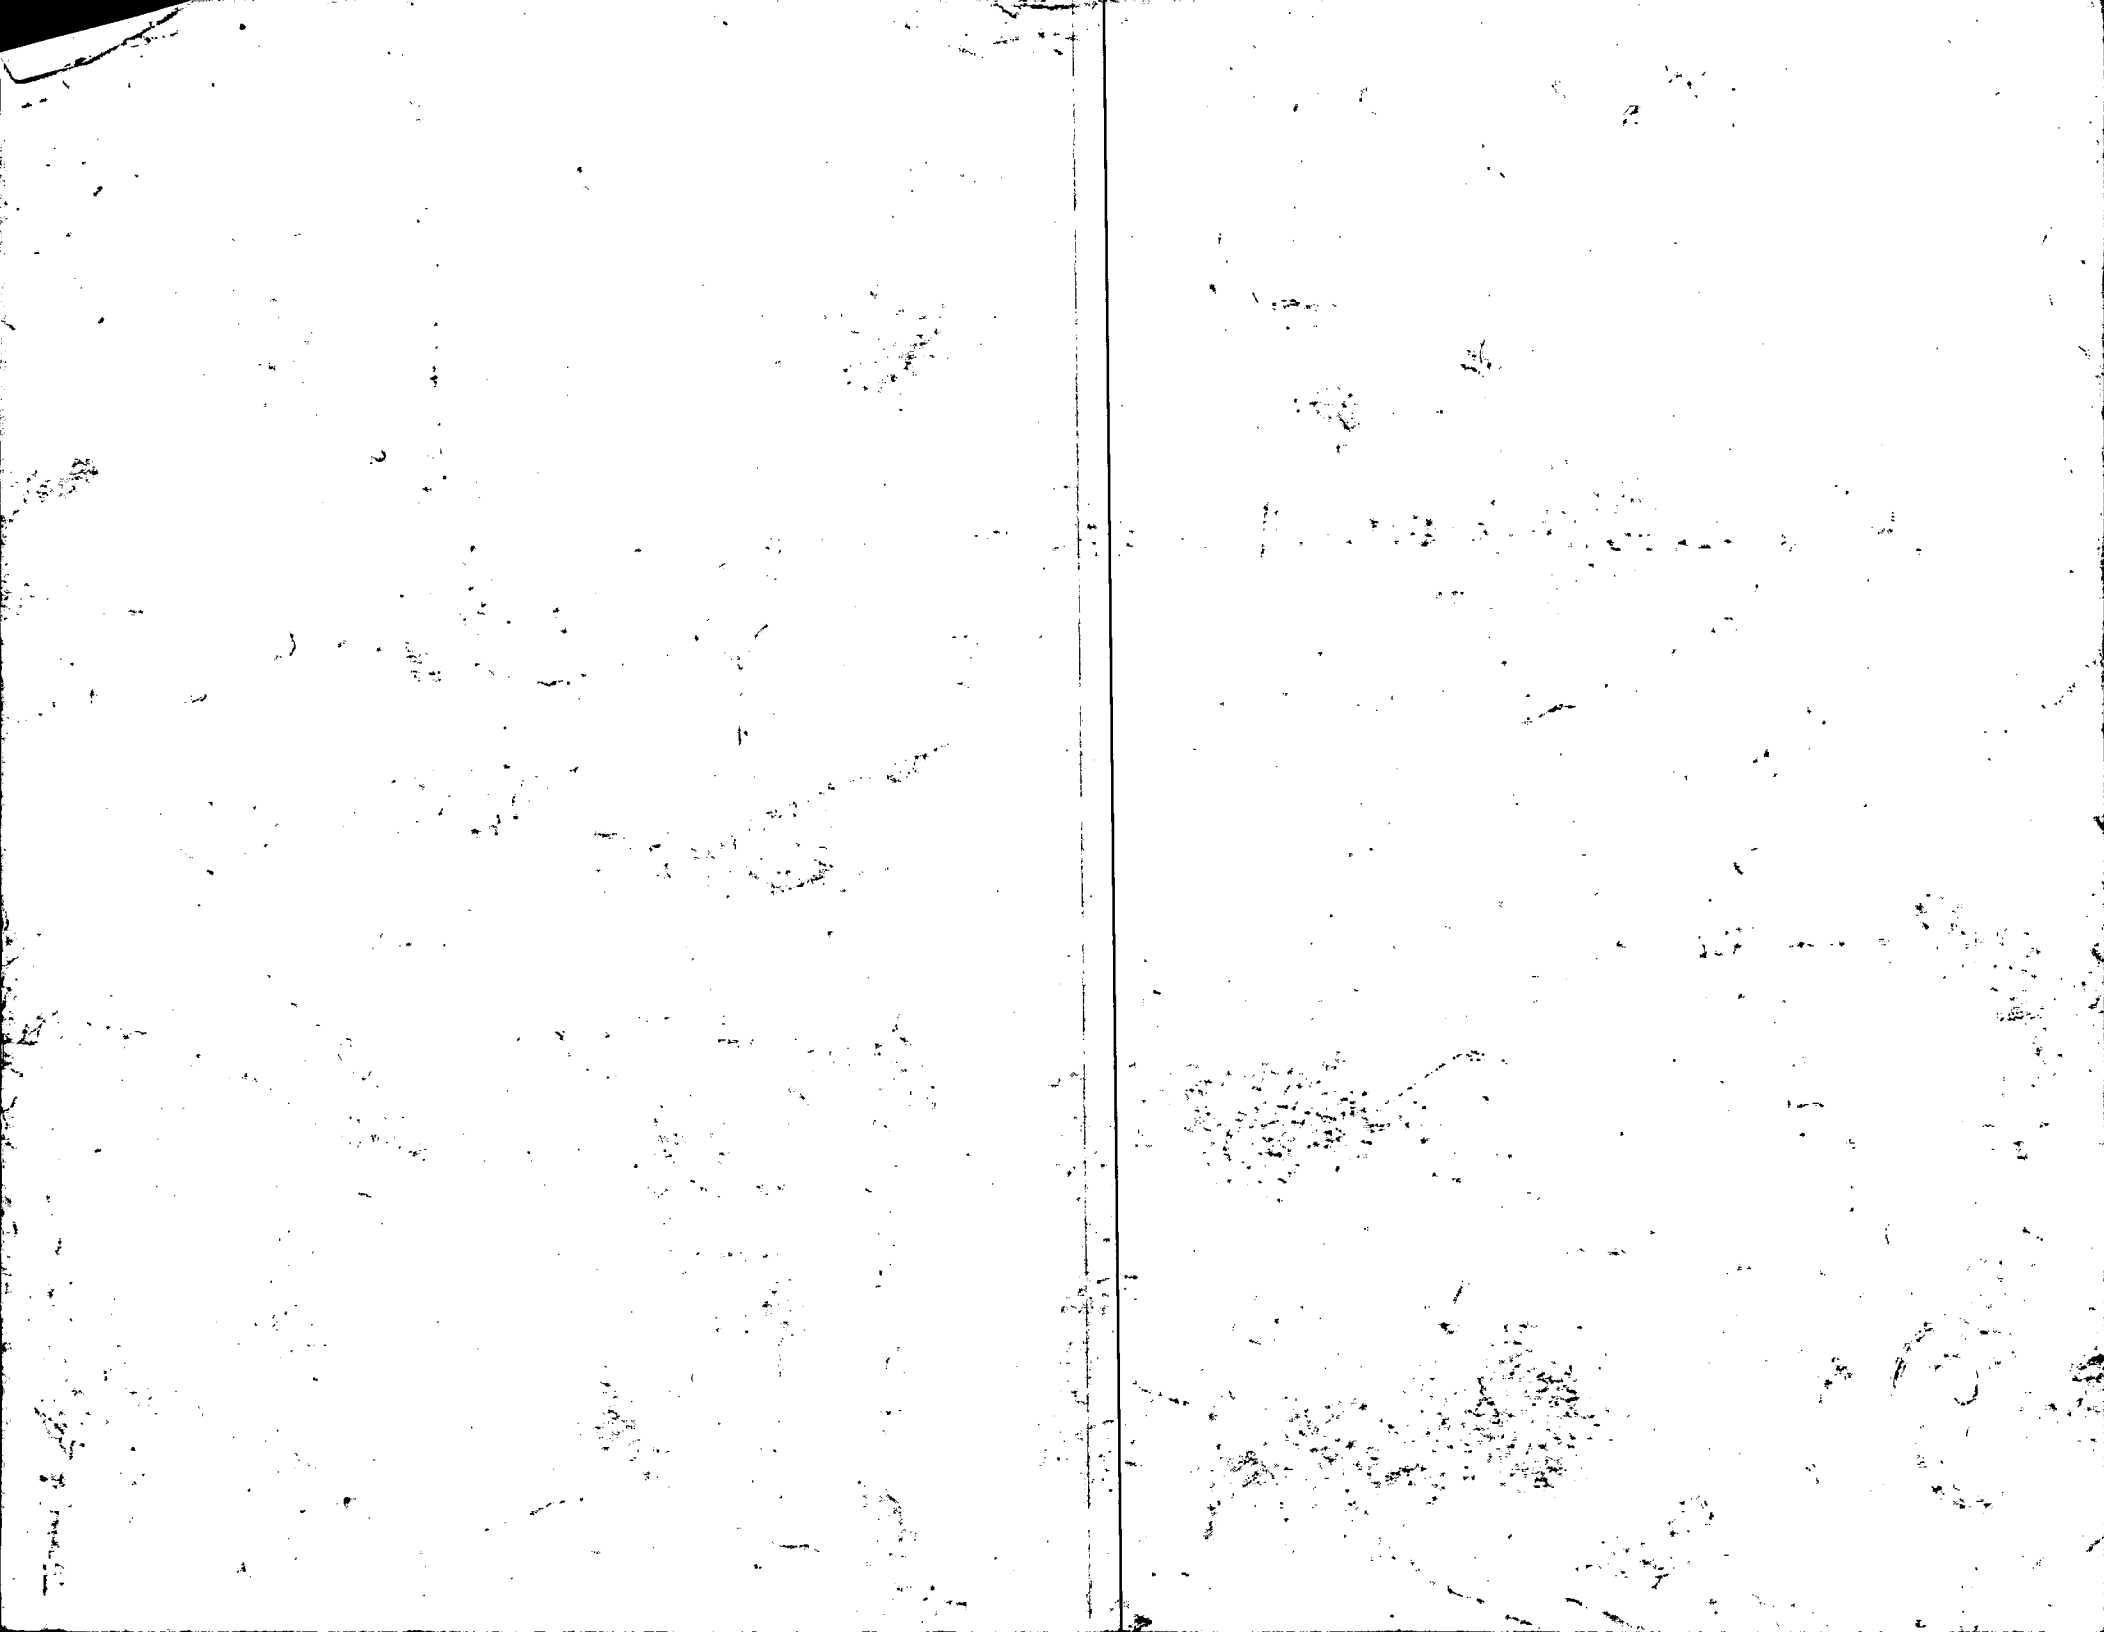

**Peter Hum**

**From:** Peter Hum [phum@dartaero.com]  
**Sent:** February 23, 2007 1:51 PM  
**To:** 'Bill Beckett'; 'S Shahbazian'; 'David Shepherd'  
**Subject:** RE: Dart 412 skidtube with Apical Floats

As discussed with Bill, we have decided to allow the release of these skidtubes with the deviation noted below

Peter

---

**From:** sjoseph@apicalind.com [mailto:sjoseph@apicalind.com]  
**Sent:** February 23, 2007 1:29 PM  
**To:** phum@dartaero.com  
**Cc:** pbravo@apicalind.com  
**Subject:** RE: Dart 412 skidtube with Apical Floats

Peter

I do not see an issue from a functional standpoint but, I am concerned that customers would object to their backed aft floats not being in alignment with the fwd and mid floats, especially since the aft floats will both lean to one side.

Steve

---

**From:** Peter Hum [mailto:phum@dartaero.com]  
**Sent:** Friday, February 23, 2007 9:50 AM  
**To:** Steve Joseph  
**Subject:** FW: Dart 412 skidtube with Apical Floats

Hi Steve,

I originally sent the question below to Pablo. I was wondering if you might be able to help.

Thanks  
Peter

---

**From:** Peter Hum [mailto:phum@dartaero.com]  
**Sent:** February 23, 2007 10:24 AM  
**To:** Pablo Bravo  
**Subject:** Dart 412 skidtube with Apical Floats

Hi Pablo,

I hope you're enjoying the California winter. We have a decent amount of snow on the ground here.

Please see my attached .pdf drawing. We are trying to send out a Dart 412 float skidtube equipped with the holes for the Apical Tri-bag system (624.8001)

The aft float bag hole provisions are designed in order to have the aft float bag be vertical (i.e. the girt is 90 degrees to the horizontal)

23/02/2007

In the manufacturing of the aft portion of the skidtube. The holes for the girt we have made are rotated 6.5 degrees with respect to the vertical, this was a manufacturing error. Therefore, when the bag is installed/or deployed it will be rotated 6.5 degrees (inboard or outboard). It will be inboard or outboard depending on which side of the aircraft the skidtube is installed, because the Dart 412 float skids aren't handed.


The forward and mid bags are okay.

Is having the aft float bag rotated by 6.5 degrees inboard or outboard still acceptable for installation on aircraft?


Thanks

Peter

BELL 412 WITH APICAL FLOATS

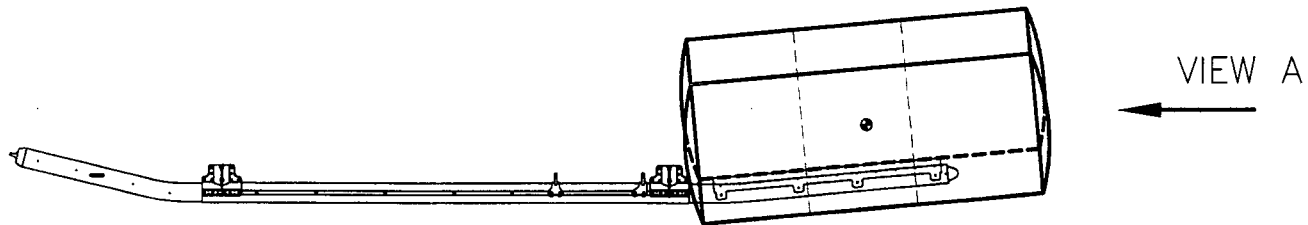

AFT FLOAT (624.8001)  
VOLUME: 67.46 CUBIC FT.

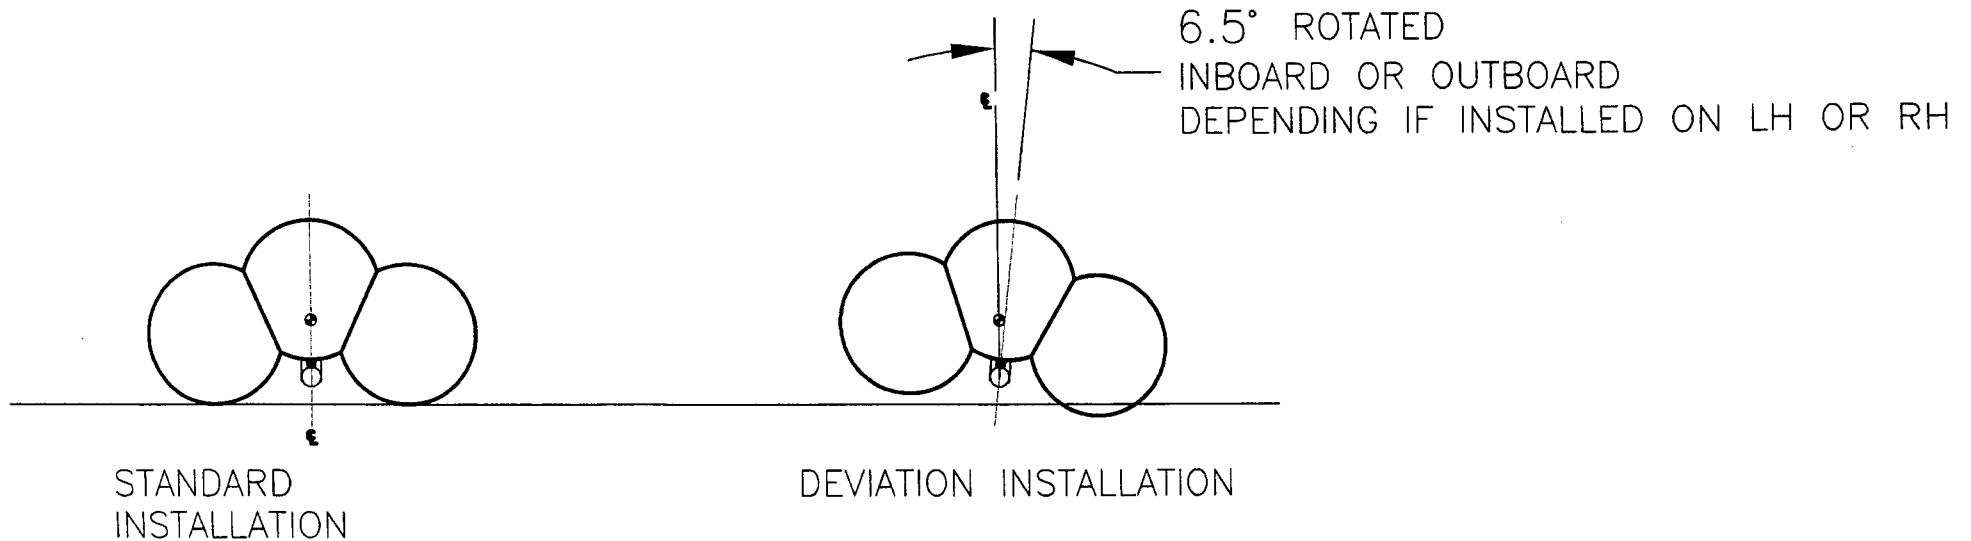

VIEW A